



Treaty Series No. 5 (1991)

Agreement

between the Government of the Republic of Iraq and the
Governments of the United Kingdom of Great Britain and
Northern Ireland, Canada, Australia, New Zealand and India

concerning the Mosul War Cemetery

Baghdad, 30 October 1989

[The Agreement entered into force on 30 October 1989]

*Presented to Parliament
by the Secretary of State for Foreign and Commonwealth Affairs
by Command of Her Majesty
January 1991*

LONDON : HMSO

£4.10 net

AGREEMENT
BETWEEN THE GOVERNMENT OF THE REPUBLIC OF IRAQ AND THE
GOVERNMENTS OF THE UNITED KINGDOM OF GREAT BRITAIN AND
NORTHERN IRELAND, CANADA, AUSTRALIA, NEW ZEALAND AND INDIA
CONCERNING THE MOSUL WAR CEMETERY

On the basis of the Agreement, concluded in Baghdad on 15 March 1935¹, between the Government of Iraq and the Governments of the United Kingdom, Canada, Australia, New Zealand, the Union of South Africa and India, concerning the British War Cemeteries, Graves and Memorial Monuments in Iraqi territory connected with the 1914-1918 War, ratified in Iraq by Law No. 56 of 1936, and the amendments to it ratified in Iraq by Law No. 62 of 1955, and in view of the fact that part of the land of the Mosul War Cemetery intersects the approaches to the fifth Mosul Bridge and in view of the wish of the Iraqi Government to organise and to execute the fifth Mosul Bridge and its approaches, agreement has been reached as follows:

ARTICLE 1

The Government of Iraq shall appropriate from the Mosul War Cemetery an area of 3075 m², three thousand and seventy five square metres, as shown in annex No. /1.

ARTICLE 2

The Government of Iraq offers as compensation for the appropriated piece of land as described in Article 1 of this Agreement, a plot of land with an area of 3075 m², three thousand and seventy five square metres, as indicated in annex No. 2, and shall ensure that such land is registered together with the rest of the Mosul War Cemetery in the name of the Commonwealth War Graves Commission.

ARTICLE 3

The Government of Iraq undertakes to carry out all the work pertaining to the transfer of graves and monuments from the appropriated plot of land to the places allocated for them in the cemetery as well as the building of the cemetery fence and the repair of damage which might result from these works as indicated in annex No. /3.

ARTICLE 4

This Agreement shall enter into force on signature.

¹ Treaty Series No. 13 (1936), Cmd. 5196.


In witness whereof the undersigned duly authorised thereto have signed this Agreement.

Done at Baghdad this thirtieth day of October 1989 in the Arabic and English languages, both texts being equally authoritative, in a single copy which shall be deposited in the archives of the Government of the Republic of Iraq and of which certified copies shall be transmitted by that Government to each of the other signatory Governments.




AKRAM-AL-WITRI

For the Government of the Republic of Iraq.

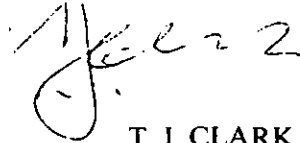

T. J. CLARK

For the Government of the United Kingdom of Great Britain and Northern Ireland.

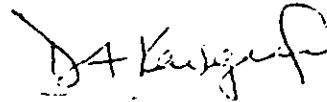

D. A. KARSGAARD

For the Government of Canada.




P. J. LLOYD

For the Government of Australia.



J. C. CLARKE

For the Government of New Zealand.




K. N. BAKSHI

For the Government of India.

ANNEX No. (3)

It has been agreed that the Government of Iraq shall compensate for the areas appropriated from the cemetery with an equivalent area of approximately 3075m² and shall carry out all necessary work connected with the relocation of the cemetery maintaining the same architectural, structural and horticultural style as the existing site.

The work required is as detailed below:

1. Clear the area of the new site, including the walls marked = = = on drawing IRAQ/MOS/11A and the existing toolshed in the south-east corner of the site. Break up all concrete foundations and floors and remove from site.
2. Make up levels to match existing gradients using selected fill in well compacted 300mm layers. Finish to existing gradients with a minimum of 300mm topsoil over the site, increasing to 2 metres of topsoil in areas where trees are to be planted.
3. Carefully take down the existing Cross of Sacrifice and seat feature and re-erect in new positions as shown on drawing IRAQ/MOS/11A and particularly in accordance with drawings IRAQ/MOS/13 and IRAQ/MOS/15.
4. Carefully take down the existing Hindu Memorial and re-erect in the new position as shown on drawing IRAQ/MOS/11A and particularly in accordance with drawing IRAQ/MOS/14.
5. Carefully take down the existing entrance feature and rebuild to the amended design detailed on drawing IRAQ/MOS/12 in the position as shown on drawing IRAQ/MOS/11A.
6. Construct a 2 metre high polygonal stone wall with weathered copings on suitable foundations in the position shown thus  on the drawing IRAQ/MOS/11A:
107 metres to the north-east boundary
58 metres to the north boundary
32.4 metres to the west boundary
130.6 metres to the south boundary
34 metres to the east boundary
81 metres to the Protestant Plot.
7. Provide openings and refix existing gates to the service entrance and Protestant Plot in the positions as shown on drawing IRAQ/MOS/11A.
8. Construct a new toolshed in the position shown on drawing IRAQ/MOS/11A and in accordance with drawing SN/MOS/10A.
9. Excavate and construct headstone beams in position shown on drawing IRAQ/MOS/11A and in accordance with Appendix A1.
10. Carefully excavate and exhume all 1939–45 war graves from the areas marked in red on the attached copy of drawing IRAQ/MOS/11A. Rebury sequentially in the positions marked on the same drawing.
11. Carefully take down 1939–45 war headstones and memorials and re-erect sequentially in the positions marked on drawing IRAQ/MOS/11A and particularly in accordance with Appendix A2.
12. Carefully excavate and exhume all remains to the Consular Graves Section and rebury in the position shown in drawing IRAQ/MOS/11A.
13. Take down existing headstones and monuments to the Consular Graves Section and re-erect in the positions shown on drawing IRAQ/MOS/11A.
14. Carefully excavate and exhume remains to the whole area of the existing Protestant Plot and rebury sequentially in the new Protestant Plot shown on drawing IRAQ/MOS/11A.
15. Take down all existing headstones and monuments to the Protestant Plot and re-erect in the new Protestant Plot.

16. Provide and fix a new mains water supply in the position shown on drawing IRAQ/MOS/11A.
17. Provide and lay, at a depth of 500mm, a 50mm diameter PN10 polyethylene reticulation system as shown on drawing IRAQ/MOS/11A.
18. On completion of the work the site should be left clean and level and free of all debris.
19. It is agreed that:
 - a. all this work and the necessary horticultural treatment which follows shall be under the supervision of an official of the Commonwealth War Graves Commission;
 - b. if import of materials is necessary for the completion of the work or the horticultural treatment, this shall be facilitated by the Government of Iraq.

اتفاق

بين حكومة الجمهورية العراقية وحكومات المملكة المتحدة
بريطانيا العظمى وايرلندا الشمالية وكندا واستراليا ونيوزيلاندا
والهند حول مقبرة الحرب في الموصل

بناء على الاتفاق الموقع في بغداد في ١٥ / آذار / ١٩٣٥
المعقود بين الحكومة العراقية وحكومات المملكة المتحدة وكندا
واستراليا ونيوزيلندا واتحاد جنوب افريقيا والهند بشأن
المقابر والقبور والانصاب التذكارية الحربية البريطانية في
الاراضي العراقية الناجمة عن حرب ١٩١٤ - ١٩١٨ المصدق
عليه في العراق بالقانون رقم ٥٦ لسنة ١٩٣٦ وتعديله
المصدق عليه في العراق بالقانون رقم ٦٢ لسنة ١٩٥٥ ،
ونظرا لتقاطع جزء من ارض مقبرة الحرب في الموصل مع
مقتربات جسر الموصل الخامس ، ورغبة من الحكومة العراقية
في تنظيم وتنفيذ جسر الموصل الخامس ومقترباته ، فقد
تم الاتفاق على ما يأتي :-

المادة (١)

ستقتطع الحكومة العراقية من مقبرة الحرب في الموصل
مساحة قدرها ٣.٧٥ ثلاثة الاف وخمسة وسبعين مترا
مربعا وكما هي مشبته في الملحق رقم ١ /

المادة (٢)

تقدم الحكومة العراقية كتعويض عن قطعة الارض المقتطعة المذكورة في المادة (١) من هذا الاتفاق ، قطعة ارض مساحتها ٣٠٧٥ ثلاثة الاف وخمسة سوبعين مترا مربعا وكما هي مثبتة في الملحق رقم ٢ . وستضمن بأن تسجل هذه الارض مع بقية مقبرة الحرب في الموصل باسم هيئة الكومنولث لقبور الحرب .

المادة (٣)


تتعهد الحكومة العراقية بالقيام بكافة الاعمال الخاصة بنقل القبور والانصاب التذكارية من قطعة الارض المقتطعة الى الاماكن المخصصة لها في المقبرة ، وكذلك بناء سياج المقبرة واصلاح الاضرار التي يمكن ان تنجم عن هذه الاعمال كما هو مثبت في الملحق رقم ٣ / .

المادة (٤)


يصح هذا الاتفاق نافذ المفعول عند توقيعه وشهادة على ذلك فان الموقعين ادناه والمخولين بالتوقيع وقعوا هذا الاتفاق .

حرر في بغداد في اليوم الثلاثين من شهر
تشرين اول / ١٩٨٩ باللفتين العربية والانكليزية ، ولكلا


النصين نفس الحجة القانونية وبنسخة واحدة تودع في
ملفات حكومة الجمهورية العراقية وترسل نسخة منها مصدقة
من قبل هذه الحكومة الى كل من الحكومات الموقعة الاخرى.

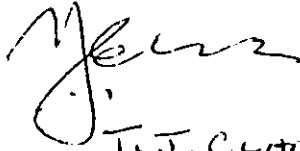
T. J. CURRY

عن حكومة المملكة المتحدة
بريطانيا العظمى وايرلندا
الشمالية

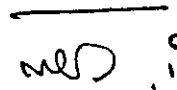
أ. س. السيد

عن حكومة الجمهورية العراقية
أدم السيد

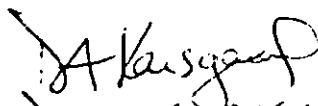
D. F. KARSGAARD

عن حكومة كندا



P. J. LLOYD
عن حكومة استراليا



J. C. CLARKE
عن حكومة نيوزيلندا



عن حكومة الهند

الملحق رقم ٣

لقد تم الاتفاق بأن تقوم الحكومة العراقية بالتعويض عن المساحة المقتطعة من المقبرة بمساحة مساوية تبلغ حوالي ٣٠٧٥ متر مربع وستقوم بكافة الاعمال اللازمة المتعلقة بتغيير موقع المقبرة محافظة على نفس النمط المعماري والبنائي والزراعي المتبع في الموقع الموجود .


وفيما يلي تفاصيل الاعمال المطلوبة

١ - ازالة الشواغل وتمهيد مساحة الموقع الجديد بما في ذلك الجدران المؤشرة ===== على الخارطة عراق/موصل ١١ أن ومخزن العدد في الزاوية الجنوبية الشرقية مسن الموقع . تكبير كافة الاسس الكونكريتية والارضيات ورفعها من الموقع .

٢ تحضير مستويات تتفق مع المنحدرات (كريد ينتز) الحالية باستعمال مواد مختارة للردم بطبقات مضغوطة جيداً وبسمك ٣٠٠ ملم . ثم التسوية لحد المنحدرات الحالية مع تربة سطحية بسمك ٣٠٠ ملم كحد ادنى فوق الموقع وزيادتها الى مترين من التربة السطحية في المناطق التي ستزرع فيها الاشجار .

٣ - رفع بعناية صليب الفداء والمقعد الحالي واعادة نصبهما في موضعيهما الجديدين كما مبين في الخارطة عراق/موصل/١١ اى وبصورة خاصة بموجب الخارطتين عراق/موصل ١٣ وعراق موصل/١٥ .

٤ - رفع بعناية النصب الهند ستاني الحالي واعادة نصبه في الموضع الجديد كما هو مبين في الخارطة عراق/موصل/١١ اى وخاصة بموجب الخارطة عراق / موصل/١٤ .


- ٥ - رفع بعناية نصب المدخل الحالي واعادة بناؤه حسب التصميم المعدل والمفصل في الخارطة عراق / موصل / ١٢ في الموضع الجديد كما مبين في الخارطة عراق / موصل / ١١ أى
- ٦ - تشييد حائط بعلو مترين من حجر متعسدد الاضلاع مع افاريز مائلة (ووذرد كوينكز) على اساس مناسبة في الموضع المبين هكذا  على الخارطة عراق / موصل / ١١ أى
- ١٠٧ امتار الى الحدود الشمالية - الشرقية
٥٨ مترا الى الحدود الشمالية
٣٢٤ مترا الى الحدود الغربية
١٣٠٦ مترا الى الحدود الجنوبية
٣٤ مترا الى الحدود الشرقية
- ٨١ مترا الى قطعة البروتستانت .
- ٧ - تهيئة فتحات واعادة تثبيت البوابات الحالية لمدخل الخدمات ولقطعة ارض البروتستانت في المواضع المبينة في الخارطة عراق / موصل / ١١ أى
- ٨ - بناء مخزن في الموضع المبين على الخارطة عراق / موصل / ١١ أى وبموجب الخارطة اس ان / موصل / ١٠ أى
- ٩ - حفر وبناء قواعد صخور الاضرحة في المواضع المبينة في الخارطة عراق / موصل / ١١ أى وبموجب الملحق أى ٠١
- ١٠ - حفر ورفع بعناية رفات كافة قبور حرب ١٩٣٩ - ١٩٤٥ من المناطق المؤشرة بالاحمر على النسخة المرفقة من الخارطة عراق / موصل / ١١ أى واعادة دفنها بالتسلسل في المواضع المؤشرة في نفس الخارطة .

- ١١- رفع بعناية صخور اضرحة حرب ١٩٣٩ - ١٩٤٥ واعادة نصبها بالتسلسل في المواضع المؤشر عليها في الخارطة عراق / موصل / ١١ أي وخاصة بموجب الملحق اي ٠٢ .
- ١٢- حفر بعناية كافة بقايا رفات قسم القبور القنصلية واعادة دفنها في المواضع المبينة في الخارطة عراق / موصل / ١١ اي .
- ١٣- رفع كافة صخور اضرحة واضرحة قسم القبور القنصلية واعادة بنائها في المواضع المبينة في الخارطة عراق / موصل / ١١ أي .
- ١٤- حفر ورفع بقايا رفات كافة منطقة قطعة البروتستانت الحالية واعادة دفنها بالتسلسل في قطعة البروتستانت الجديدة المبينة على الخارطة عراق / موصل / ١١ أي .
- ١٥- رفع كافة صخور اضرحة واضرحة قطعة البروتستانت الحالية واعادة نصبها في قطعة البروتستانت الجديدة .
- ١٦- تجهيز ونصب مصادر رئيسية لتجهيز الماء في الموضع المبين في الخارطة عراق / موصل / ١١ أي
- ١٧- تزويد وتمديد على عمق ٥٠٠ ملم نظام تشابكي (ريتكوليشن سستم) من بي ان ١٠ بوليثيلين بقطر ٥٠ ملم كما هو مبين على الخارطة عراق / موصل / ١١ اي
- ١٨- عند انجاز العمل يجب ان يترك نظيفا ومستويا وخاليا من كافة الانقاض .
- ١٩- لقد تم الاتفاق :-
آ - بأن يتم هذا العمل والمعالجة الزراعية اللازمة التي ستلي ذلك تحت رقابة مسؤؤل من هيئـة الكومنولث لقبور الحرب .
ب - اذا كان استيراد المواد ضروريا لانجاز اعمال

المعالجة الزراعية فإن الحكومة العراقية ستقوم بتسهيل
ذلك .

١٠/١٠
١٠/١٠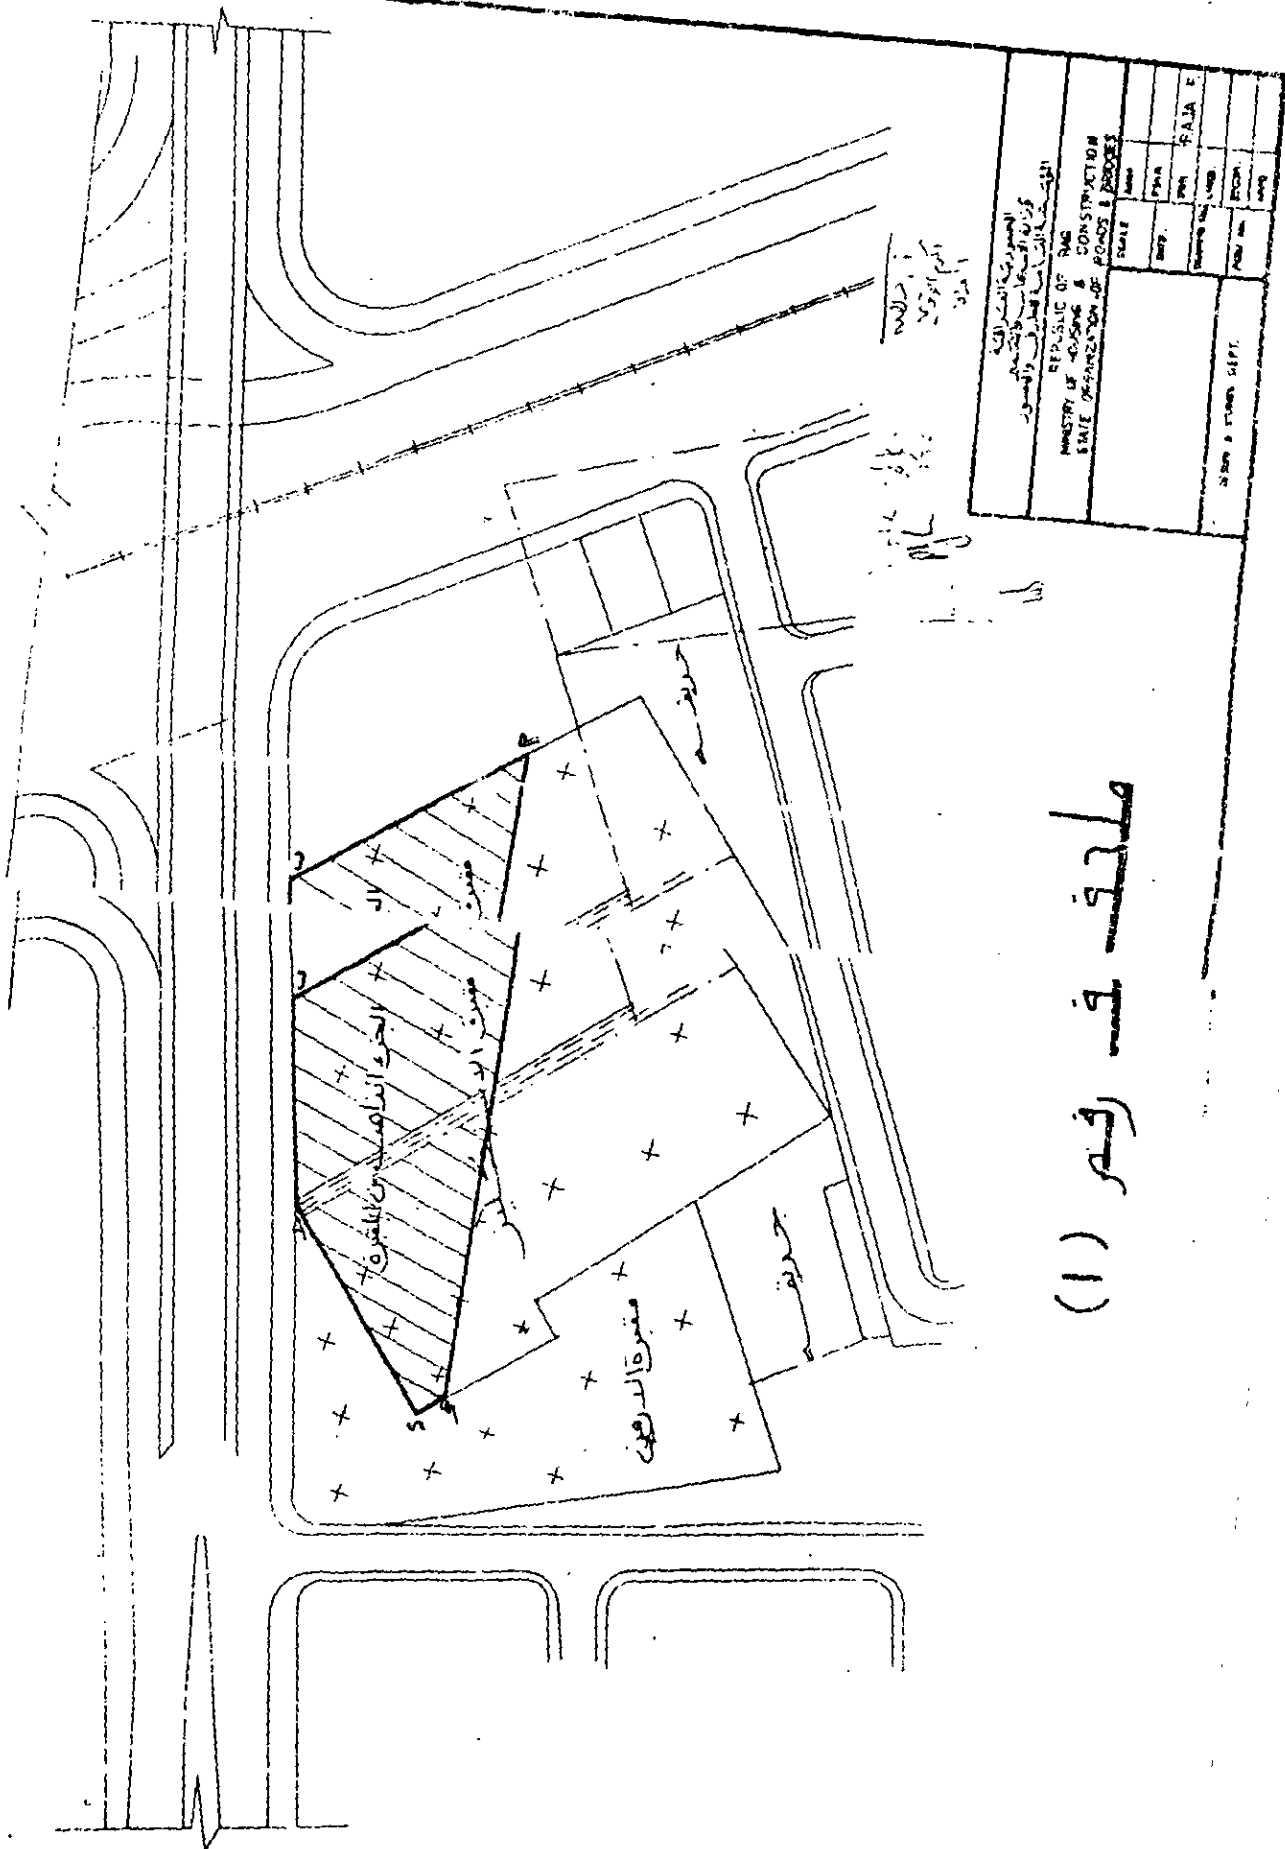
مبنى 1
مبنى 2
مبنى 3

ملحق رقم (1)







الجمهورية العراقية وزارة التخطيط والتعمير والنوسن الهيئة العامة للتخطيط والتعمير والنوسن		REPUBLIC OF IRAQ MINISTRY OF HOUSING & CONSTRUCTION STATE DEPARTMENT OF PLANNING & RECONSTRUCTION	
رقم المخطط Date	رقم المخطط Date	رقم المخطط Date	رقم المخطط Date
رقم المخطط Date	رقم المخطط Date	رقم المخطط Date	رقم المخطط Date
رقم المخطط Date		رقم المخطط Date	

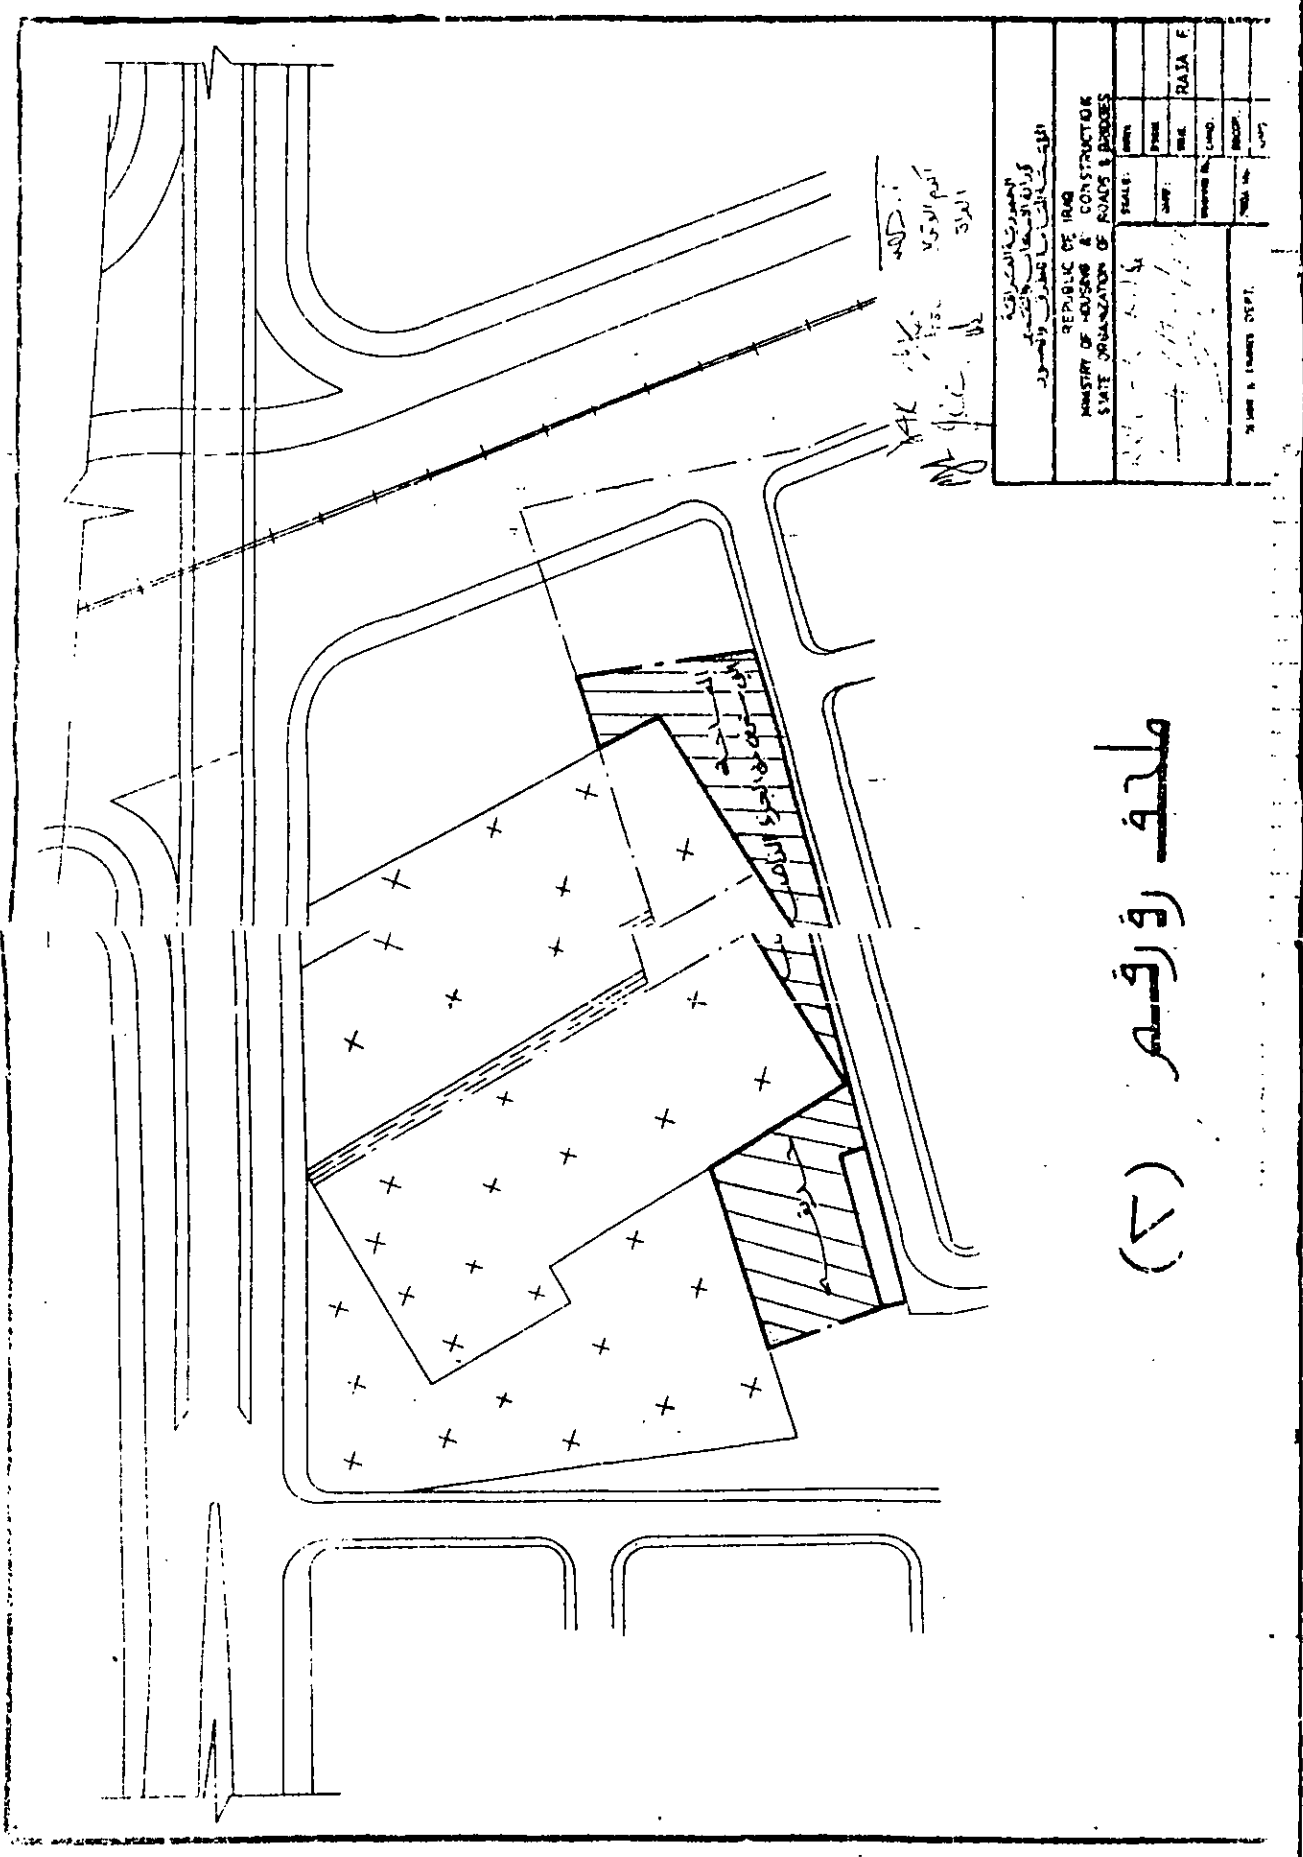





الدولة العراقية
 وزارة التخطيط والتشييد
 وزارة الإسكان والبناء
 وزارة النقل والبنية التحتية
 وزارة الكهرباء والماء
 وزارة الزراعة والثروة السمكية
 وزارة الثقافة والاعمال
 وزارة التعليم العالي والبحث العلمي
 وزارة الصحة
 وزارة البيئة والمياه
 وزارة السياحة والآثار
 وزارة العدل
 وزارة الخارجية
 وزارة الدفاع
 وزارة المالية
 وزارة التجارة
 وزارة العمل
 وزارة الشباب والرياضة
 وزارة المرأة
 وزارة التخطيط والتشييد
 وزارة الإسكان والبناء
 وزارة النقل والبنية التحتية
 وزارة الكهرباء والماء
 وزارة الزراعة والثروة السمكية
 وزارة الثقافة والاعمال
 وزارة التعليم العالي والبحث العلمي
 وزارة الصحة
 وزارة البيئة والمياه
 وزارة السياحة والآثار
 وزارة العدل
 وزارة الخارجية
 وزارة الدفاع
 وزارة المالية
 وزارة التجارة
 وزارة العمل
 وزارة الشباب والرياضة
 وزارة المرأة

الجمهورية العراقية وزارة التخطيط والتشييد وزارة الإسكان والبناء وزارة النقل والبنية التحتية وزارة الكهرباء والماء وزارة الزراعة والثروة السمكية وزارة الثقافة والاعمال وزارة التعليم العالي والبحث العلمي وزارة الصحة وزارة البيئة والمياه وزارة السياحة والآثار وزارة العدل وزارة الخارجية وزارة الدفاع وزارة المالية وزارة التجارة وزارة العمل وزارة الشباب والرياضة وزارة المرأة	
REPUBLIC OF IRAQ MINISTRY OF HOUSING & CONSTRUCTION STATE ORGANIZATION OF ROADS & BRIDGES	
SCALE:	DATE:
PROJECT NO.:	RAIA F
DESIGNER:	NO.:
DATE:	NO.:
ROAD & BRIDGE DEPT.	

ملف رقم (٧)

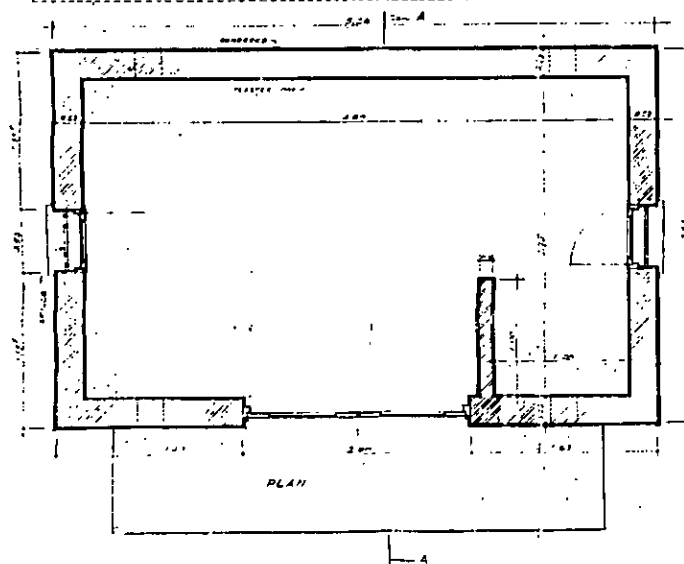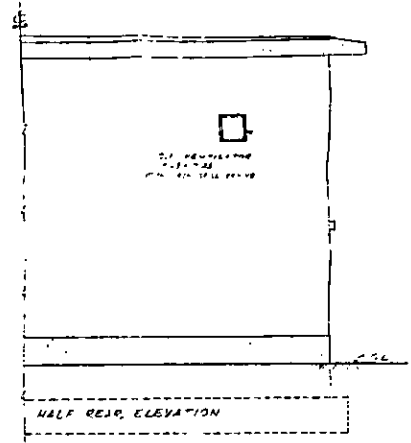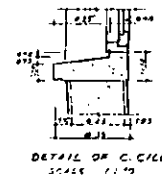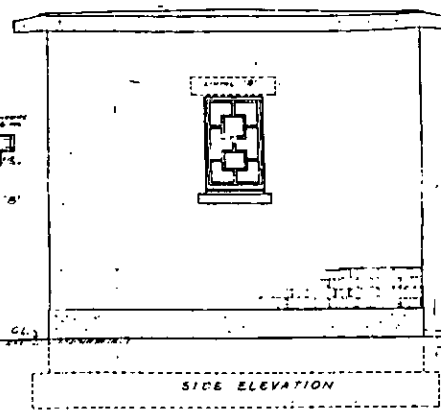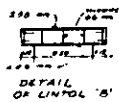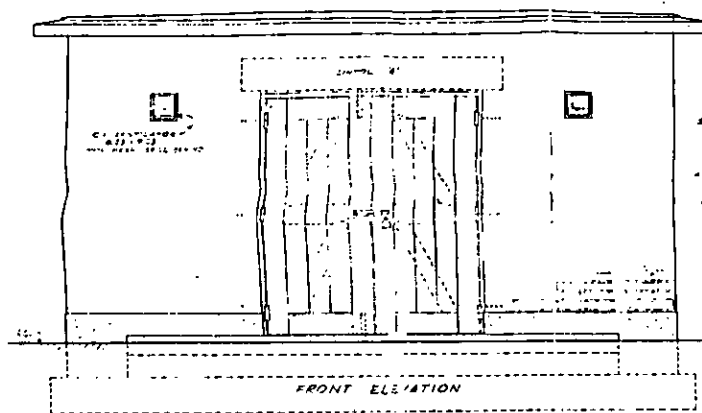

SCALE 1/20

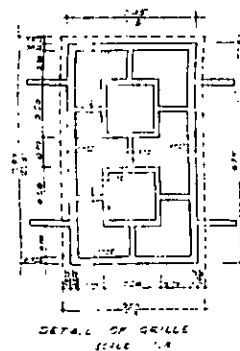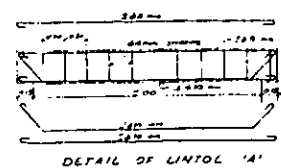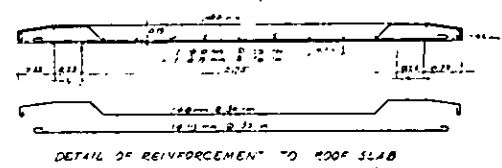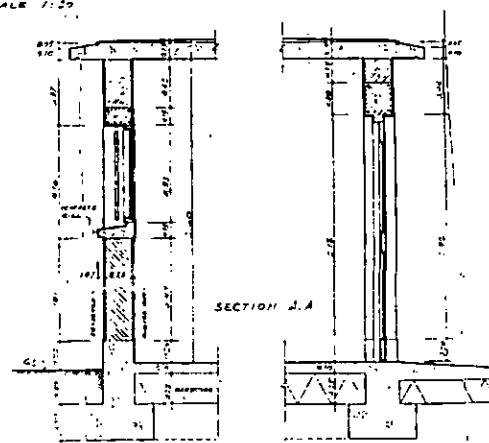


REVISIONS
 1. 18/10/54
 2. 21/10/54
 3. 21/10/54
 4. 21/10/54
 5. 21/10/54
 6. 21/10/54
 7. 21/10/54
 8. 21/10/54
 9. 21/10/54
 10. 21/10/54


DESIGNED BY
 DRAWN BY
 CHECKED BY
 APPROVED BY
 OFFICER

MOSUL WAR CEMETERY
 PROPOSED GARDENERS STORE

54 NOS / 10A
 1/10/54

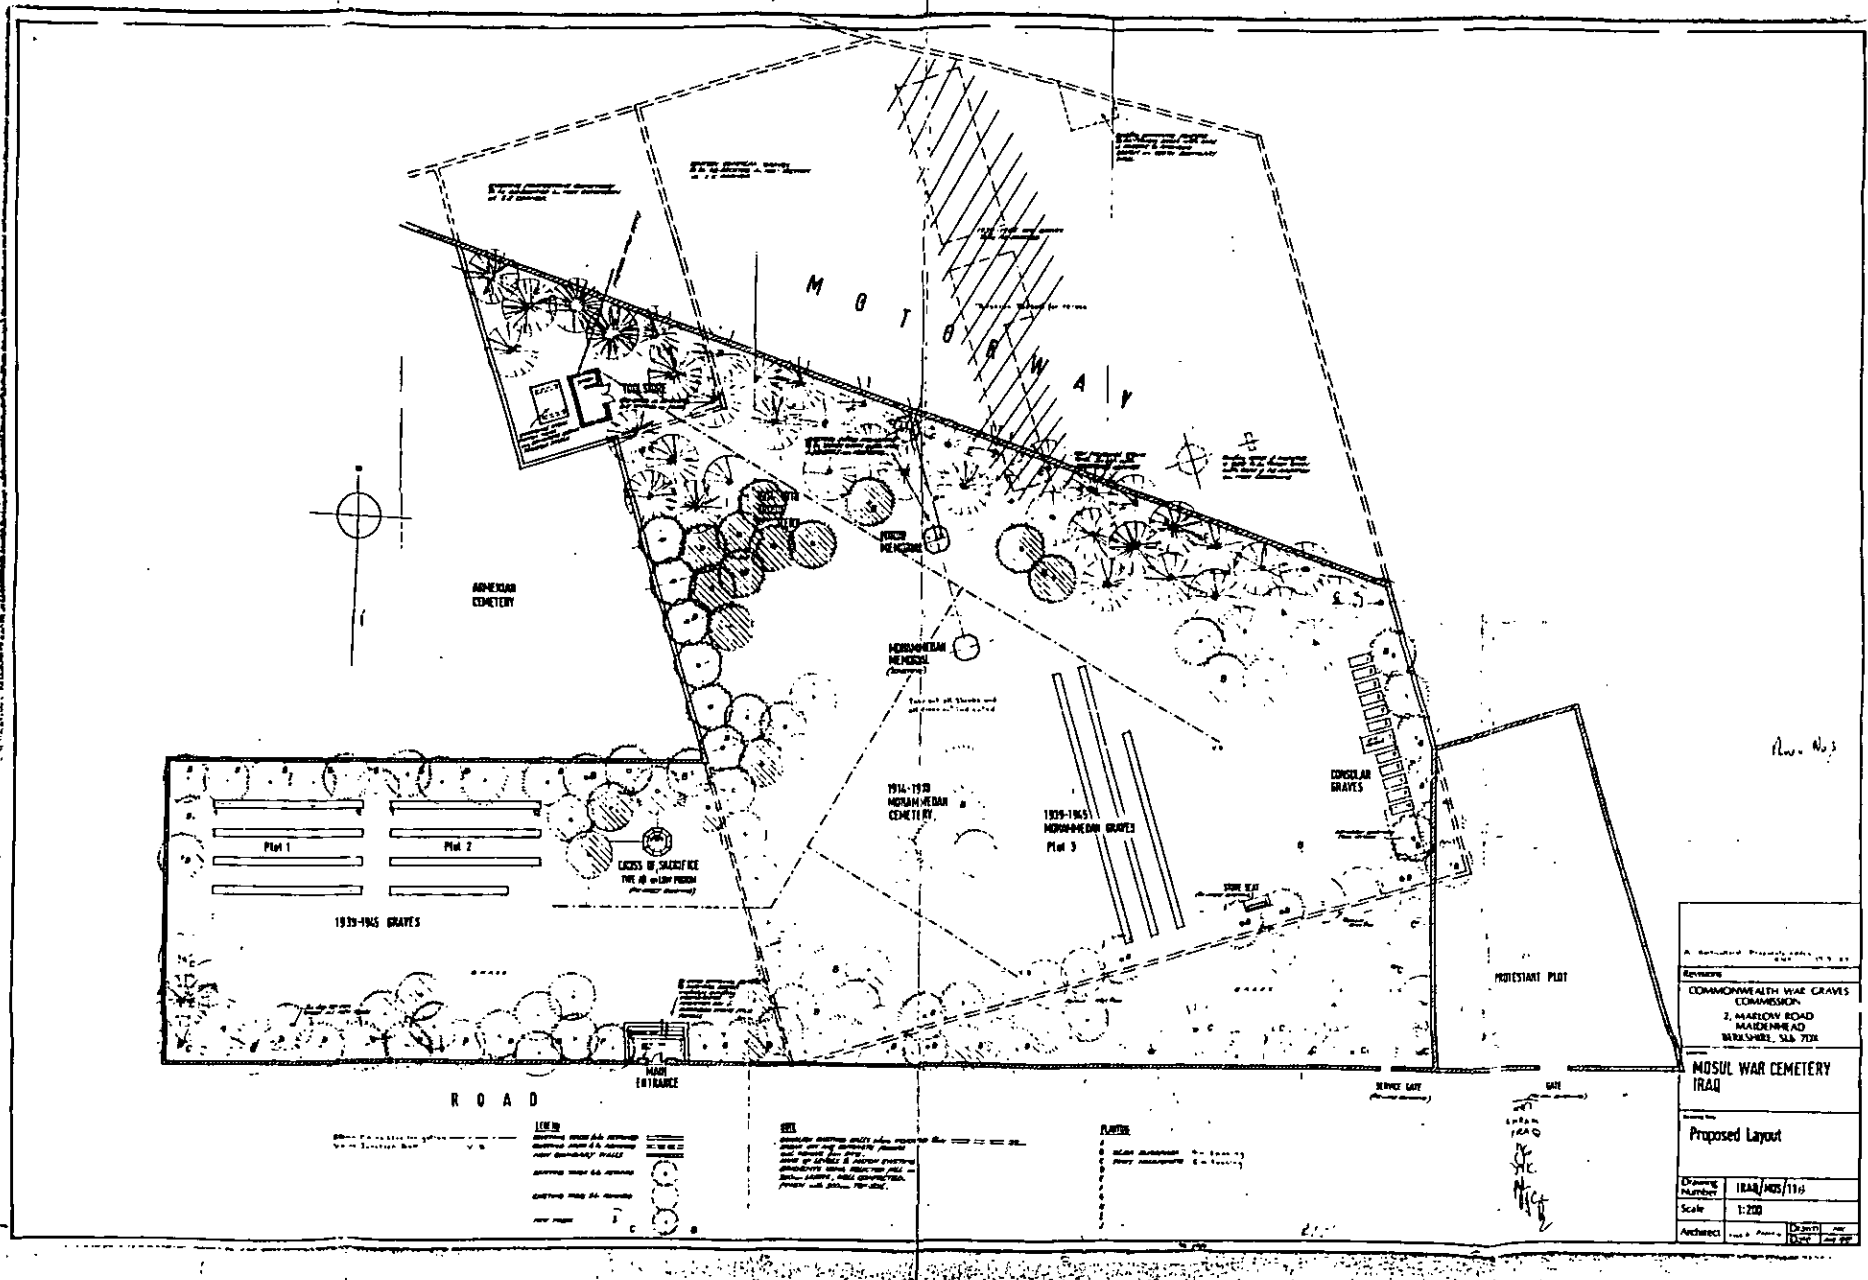


A. National Project, 1944-1945	
Revised	
COMMONWEALTH WAR GRAVES COMMISSION	
2, MARLOW ROAD MARLOW, BUCKINGHAMSHIRE, SLA 7DU	
MOSUL WAR CEMETERY IRAQ	
Proposed Layout	
Drawn by	IRAG/MS/116
Scale	1:200
Architect	IRAG/MS/116

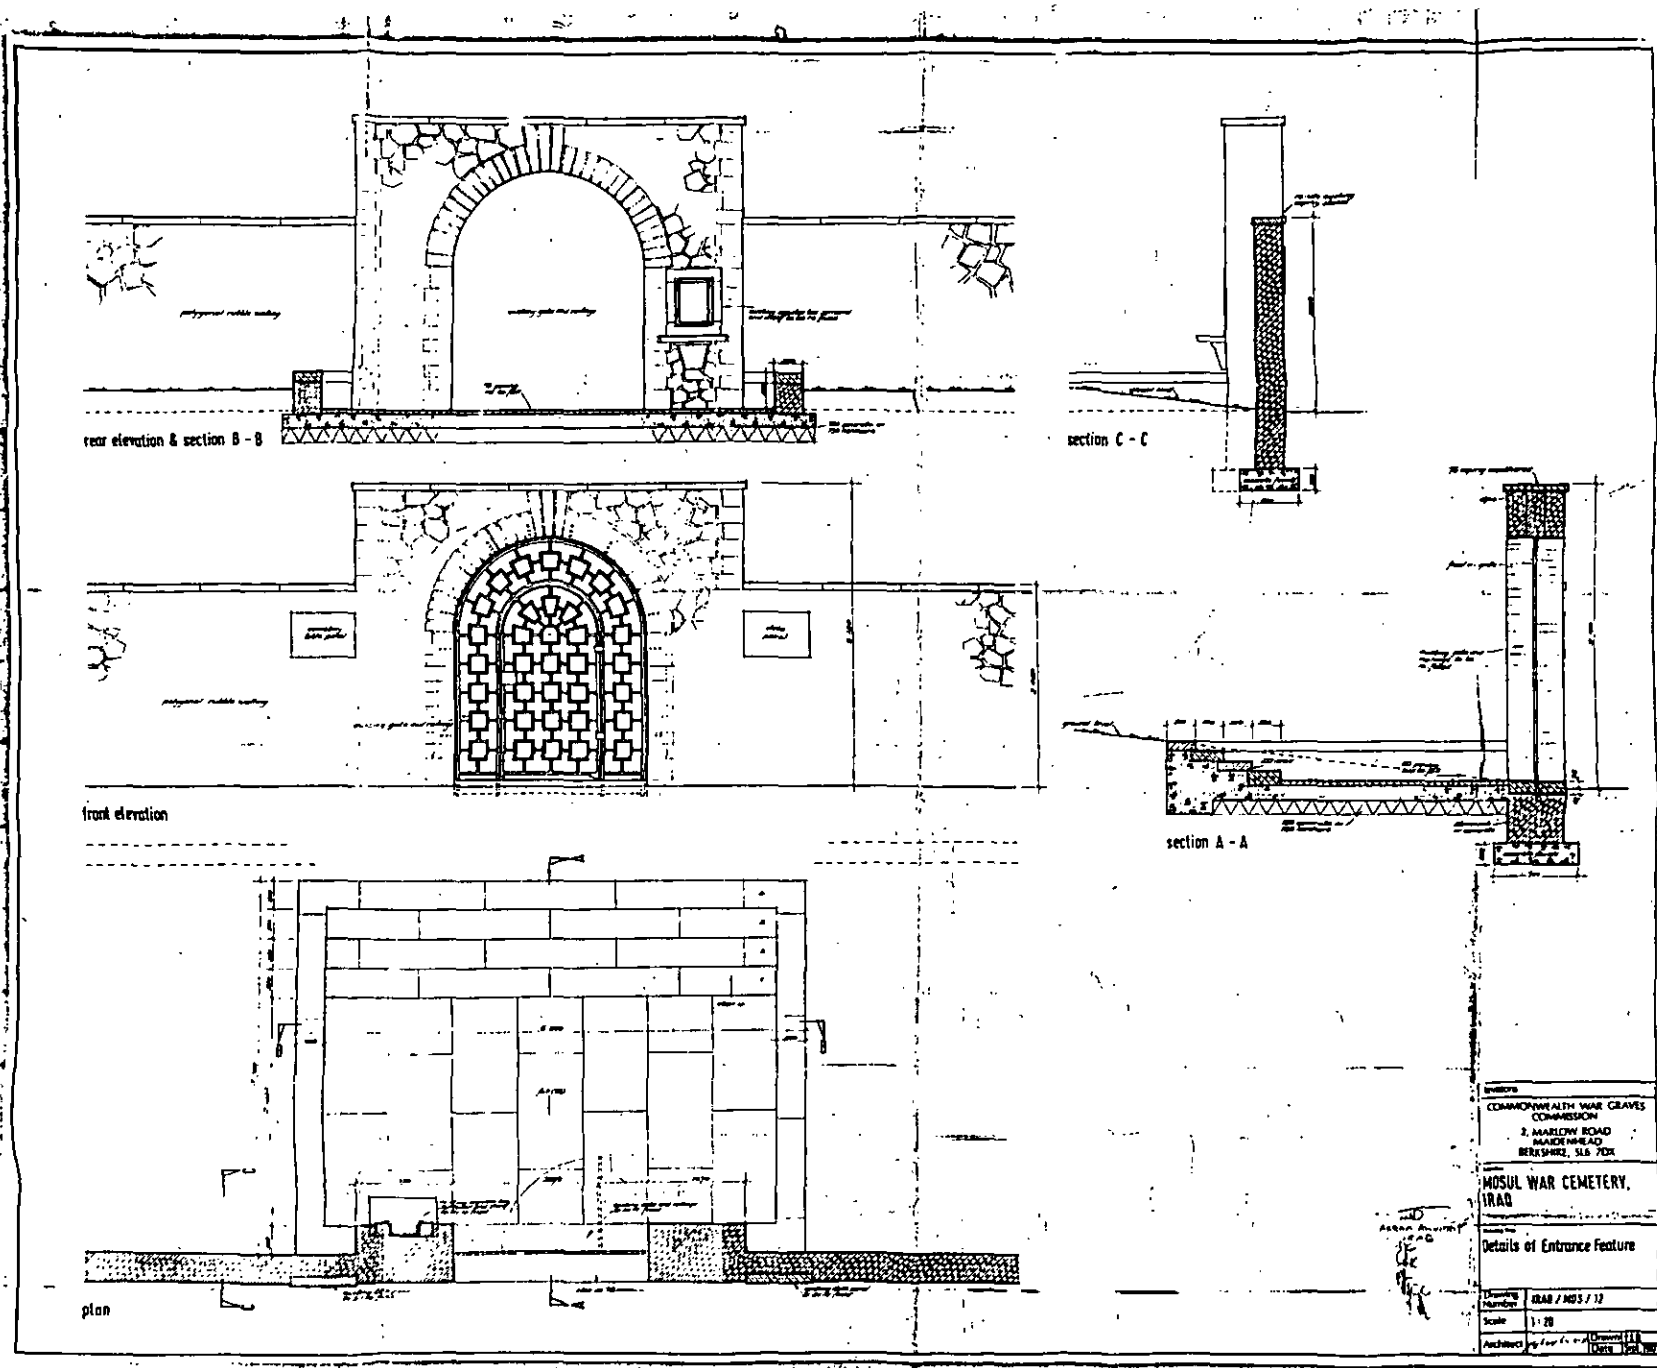


ANNEX No. 3(3)


COMMONWEALTH WAR GRAVES COMMISSION 2, MARLEW ROAD MARLEW HILL, BERKSHIRE, SL6 7DX	
MOSUL WAR CEMETERY, IRAQ	
Details of Entrance Feature	
Drawing Number	IRAB / MOS / 12
Scale	1:20
Architect	[Signature]

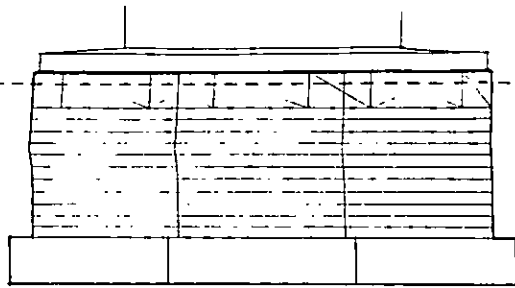


rear elevation

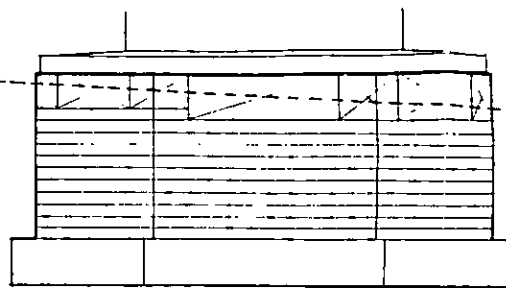


side elevation

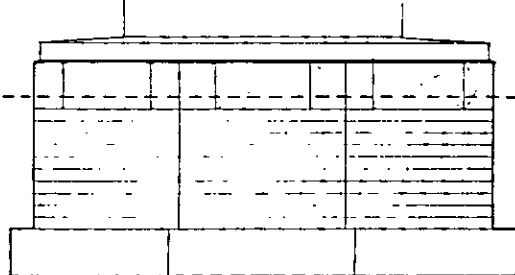

front elevation

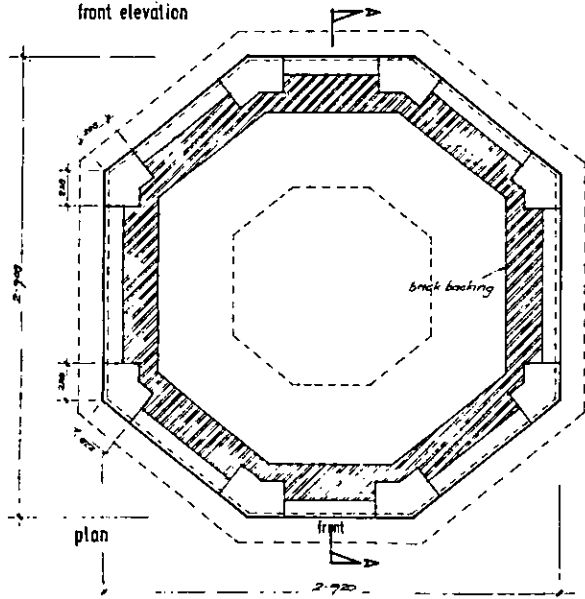

plan

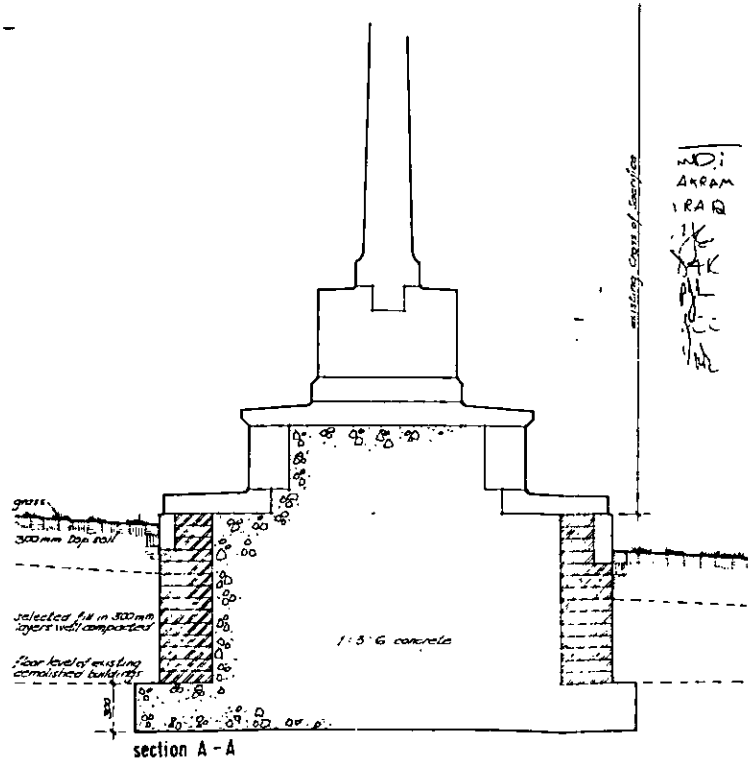


section A - A

W.D.
A.R.A.M.
I.R.A.D.
P.L.K.
P.L.K.
P.L.K.


plans No 3
(4)

Notes					
<p>Revisions</p> <p>COMMONWEALTH WAR GRAVES COMMISSION 2, MARIOW ROAD MAIDENHEAD BERKSHIRE, SL6 7DX</p> <p>Location MOSUL WAR CEMETERY, IRAQ.</p> <p>Drawing Title Details of Podium for Cross of Sacrifice (type A/1)</p>					
Drawing Number	IRAQ / MOS / 13				
Scale	1:20				
Architect	<table border="1"> <tr> <td>Drawn</td> <td>PJB</td> </tr> <tr> <td>Date</td> <td>Sept 1987</td> </tr> </table>	Drawn	PJB	Date	Sept 1987
Drawn	PJB				
Date	Sept 1987				

ANNEX No. 3(4)

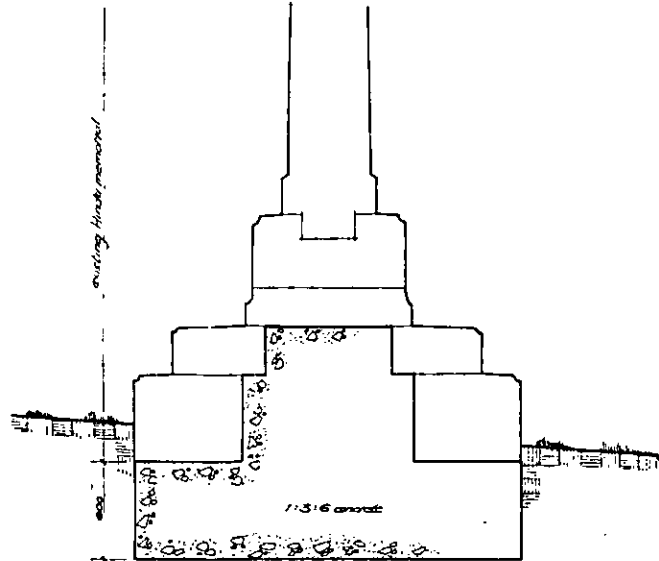

section A - A

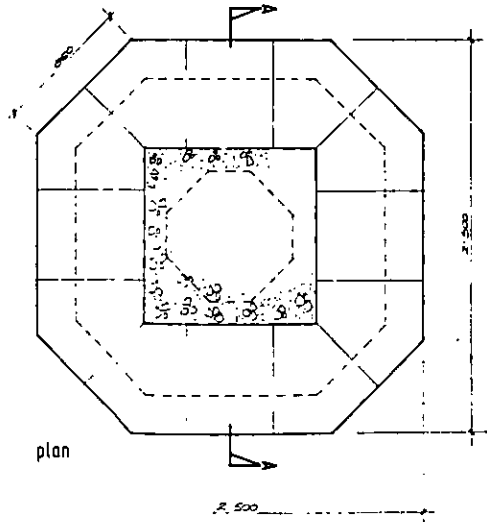


plan

MP. i
 ANZAC WARR. IRQ.
 IRAQ
 JK
 SKK
 PL
 FCC
 BL

Notes

plans No 3
 (5)


Revisions	
COMMONWEALTH WAR GRAVES COMMISSION 2, MARLOW ROAD MIDENHEAD BERKSHIRE, SL6 7DX	
Location MOSUL WAR CEMETERY, IRAQ.	
Drawing Title Foundations for Hindu Memorial.	
Drawing Number	IRAQ / MOS / 14
Scale	1:20
Architect	John Wilton
Drawn	P. B.
Date	1 Oct 1988

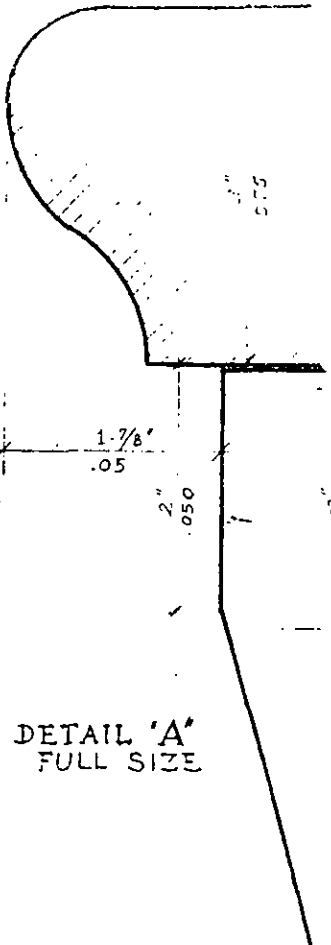

DETAIL 'A'
FULL SIZE




ELEVATION

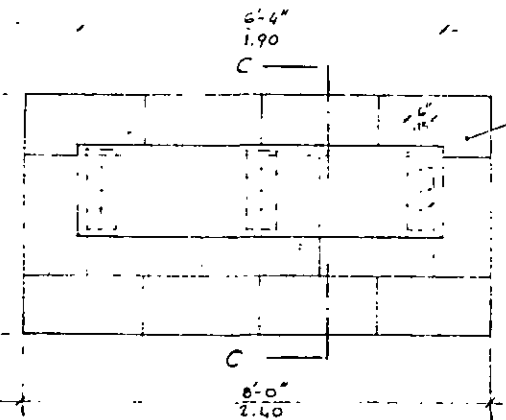


PLAN

SCALE 1/2" = 1'-0"

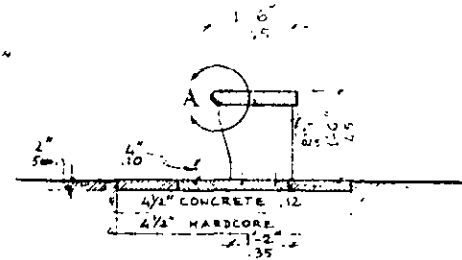

SECTION C-C

BRONZE DOWELS
 BAYING IN LIGHT TRAVERTINE SLABS WITH RUBBED FINISH (5mm THICK)

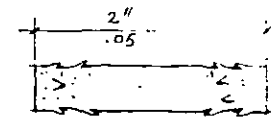



F.S. DETAIL of BRONZE DOWELS
 (No. 9 REQUIRED FOR EACH FEATURE)

COMMONWEALTH WAR GRAVES
 COMMISSION
 2 MARLOW ROAD
 MAIDENHEAD
 BERKSHIRE, SL6 7DX

MOSUL WAR CEMETERY, IRAQ
 Details of Stone Seat

Handwritten notes and signatures, including 'IRAQ' and 'JTK'.

Drawing Number	IRAQ / MOS / 15		
Scale	as shown		
Architect	Drawn		
	Date	Oct 1987	

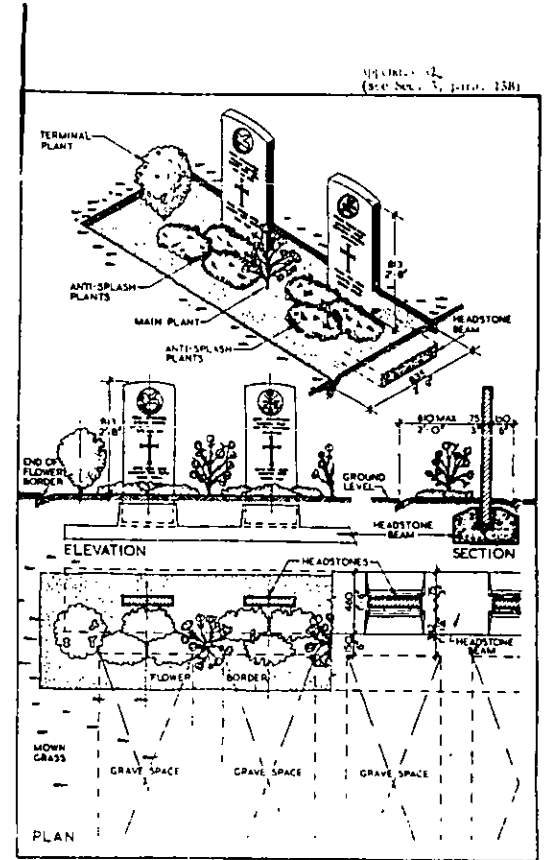
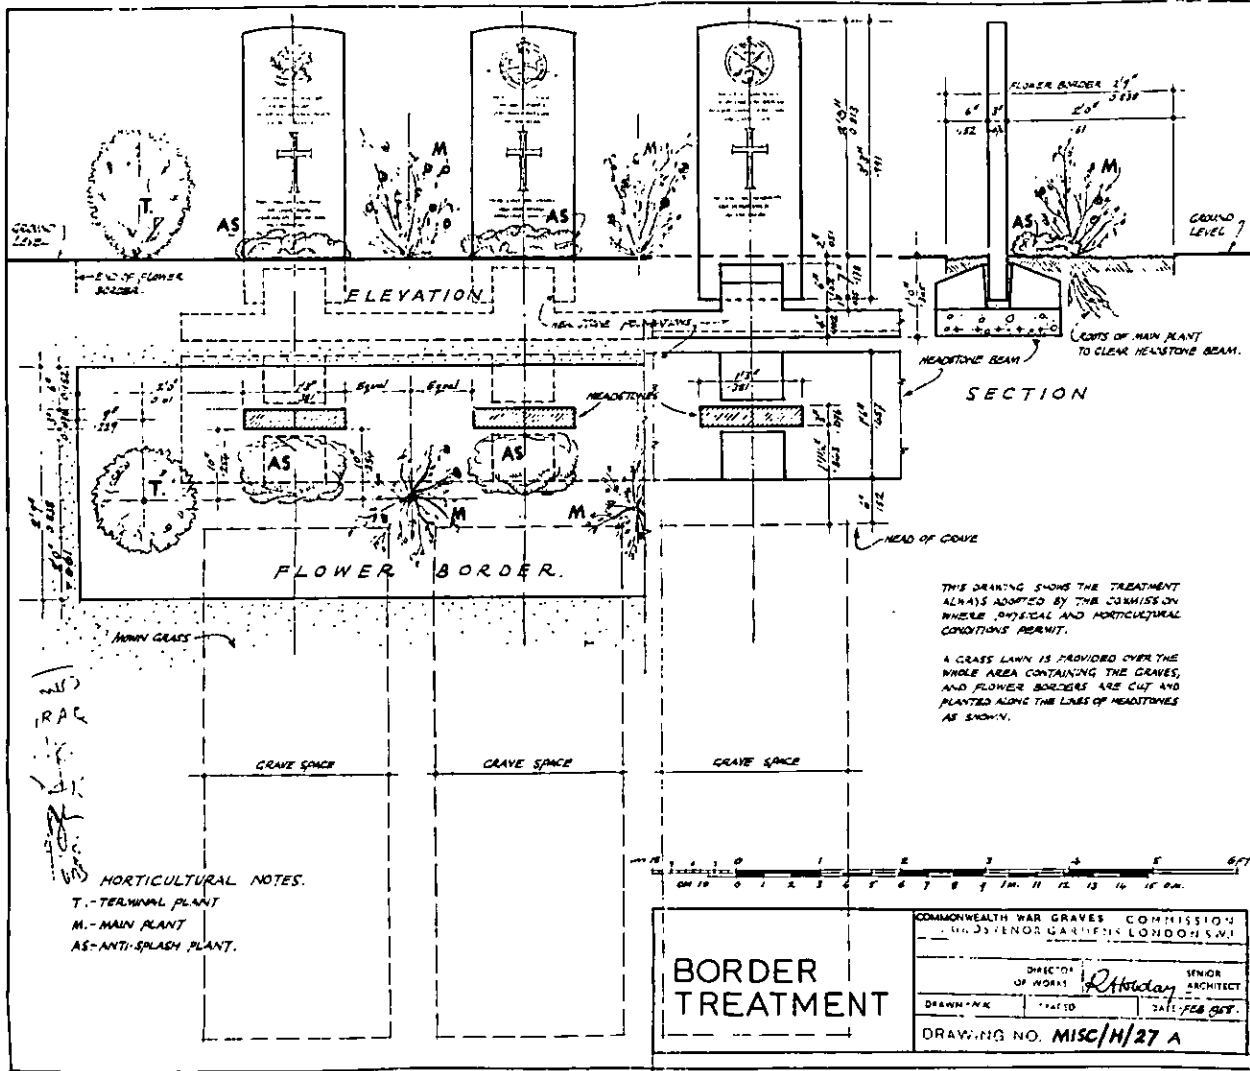


NOTES

CONCRETE
 THE PROPORTIONS OF CONCRETE FOR BEAMS AND SUPPORTS ARE TO BE 1 PART CEMENT, 2 PARTS SAND, 3 PARTS MEDIUM FINE AGGREGATE.
 BEAMS ARE NORMALLY TO BE SEPARATED INTO LENGTHS TO TAKE THREE, AND NEVER MORE THAN FIVE, HEADSTONES BY THE FORMATION OF TAPERED JOINTS, WHICH, ON COMPLETION, ARE TO BE FILLED WITH SAND. IMMEDIATELY THE CONCRETE IN EACH LENGTH OF BEAM HAS BEEN FINISHED, LEVELLED AND TRIMMED, THE FORMS FOR SUPPORTS WILL BE PLACED IN POSITION AND ADJUSTED TO THE SURFACE OF THE BEAM WITHIN THE FORMS WILL THEN BE SCAMPED AS SHOWN AND THE CONCRETE SUPPORTS ROISED, THE WHOLE PROCESS BEING CARRIED OUT WITH NECESSARY HANDY TO ENSURE MONOLITHIC CONSTRUCTION OF BEAM AND SUPPORTS.
 5. A PERIOD OF 10 DAYS IS TO ELAPSE FOR CURING BEFORE HEADSTONES ARE FIXED, DURING THIS PERIOD, IF THE COMMISSIONER REPRESENTATIVE CONSIDERS THE WEATHER CONDITIONS DEMAND IT, THE CONTRACTOR SHALL COVER THE WORK OR PERIODICALLY WATER IT AS MAY BE ORDERED.

FIXING OF HEADSTONES
 1. EACH HEADSTONE IS TO BE SET UP ALIGNED BY THE TOP CORNER AND ACCURATELY ALIGNED BY THE TOP CORNER.
 2. WEDGES SHALL BE USED AFTER THE APPROVAL OF THE COMMISSIONER REPRESENTATIVE WILL GRANTING BE DONE WITH A WEAK MORTAR CONSISTING OF 1 PART OF CEMENT TO 10 PARTS OF SAND.
 3. AFTER A PERIOD OF 24 HOURS THE WEDGES ARE TO BE WITHDRAWN AND THE HOLES THEY LEAVE TO BE FILLED WITH MORTAR.
 4. IN NO CIRCUMSTANCES IS ANY TRIMMER TO BE TAKEN TO AVOID STAINING THE HEADSTONE.
 5. THROUGHOUT THE OPERATION CARE MUST BE TAKEN TO AVOID STAINING THE HEADSTONE.
 6. WHEN A HEADSTONE IS NOT AVAILABLE FOR SECTION, THE PORTION OF TRENCH FOR THE LENGTH OF ITS SUPPORTS IS TO BE FILLED WITH SAND, AND THE REMAINDER WITH VEGETABLE SOIL. WHEN THE HEADSTONE IS EVENTUALLY ERECTED, THE SAND FILLING IS TO BE REPLACED BY VEGETABLE SOIL.

STANDARD HEADSTONE BEAMS
 SCALE: ONE INCH TO ONE FOOT
 COMMONWEALTH WAR GRAVES COMMISSION,
 2 MARLBOROUGH ROAD, WINDHOLM, BIRMINGHAM, ENGLAND.
 DRAWN BY: P. J. R. DATE: 6.12.54
 DIRECTOR OF WORKS
 DRG NO MISC/H/38

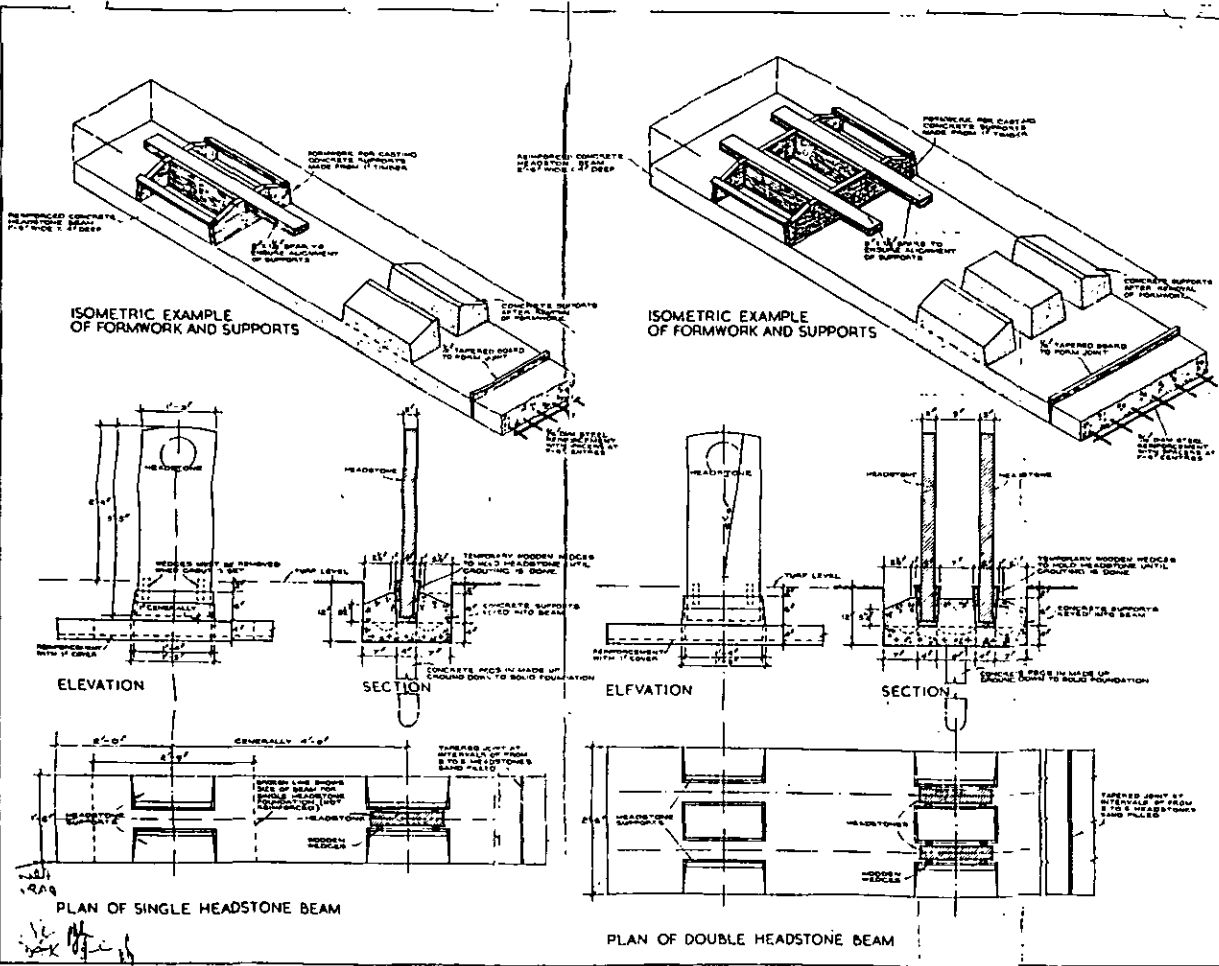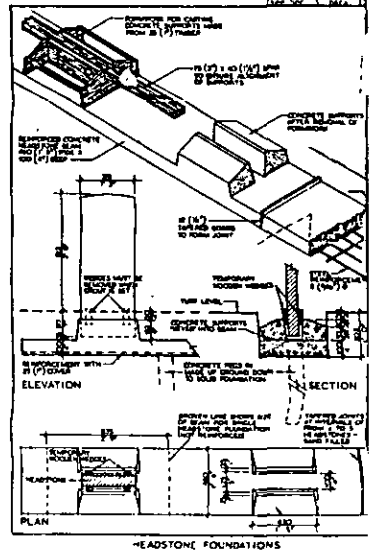



HMSO publications are available from:

HMSO Publications Centre

(Mail and telephone orders only)
PO Box 276, London SW8 5DT
Telephone orders 071-873 9090
General enquiries 071-873 0011
(queuing system in operation for both numbers)

HMSO Bookshops

49 High Holborn, London, WC1V 6HB 071-873 0011 (Counter service only)
258 Broad Street, Birmingham, B1 2HE 021-643 3740
Southey House, 33 Wine Street, Bristol, BS1 2BQ (0272) 264306
9-21 Princess Street, Manchester, M60 8AS 061-834 7201
80 Chichester Street, Belfast, BT1 4JY (0232) 238451
71 Lothian Road, Edinburgh, EH3 9AZ 031-228 4181

HMSO's Accredited Agents
(see Yellow Pages)

and through good booksellers

ISBN 0-10-113992-6



9 780101 139922